




FOR SPOT ELEVATIONS
SEE RI-355-H400 SERIES DWGS.
FOR TYPICAL SECTIONS AT STRUCTURES
SEE DWG. RI-355-H613
FOR CP MEDIAN WALL DETAILS
SEE DWG. RI-355-S103, S104, S105

L1000 DESIGN SPEED 90 km/h

BRUNETTE INTERCHANGE

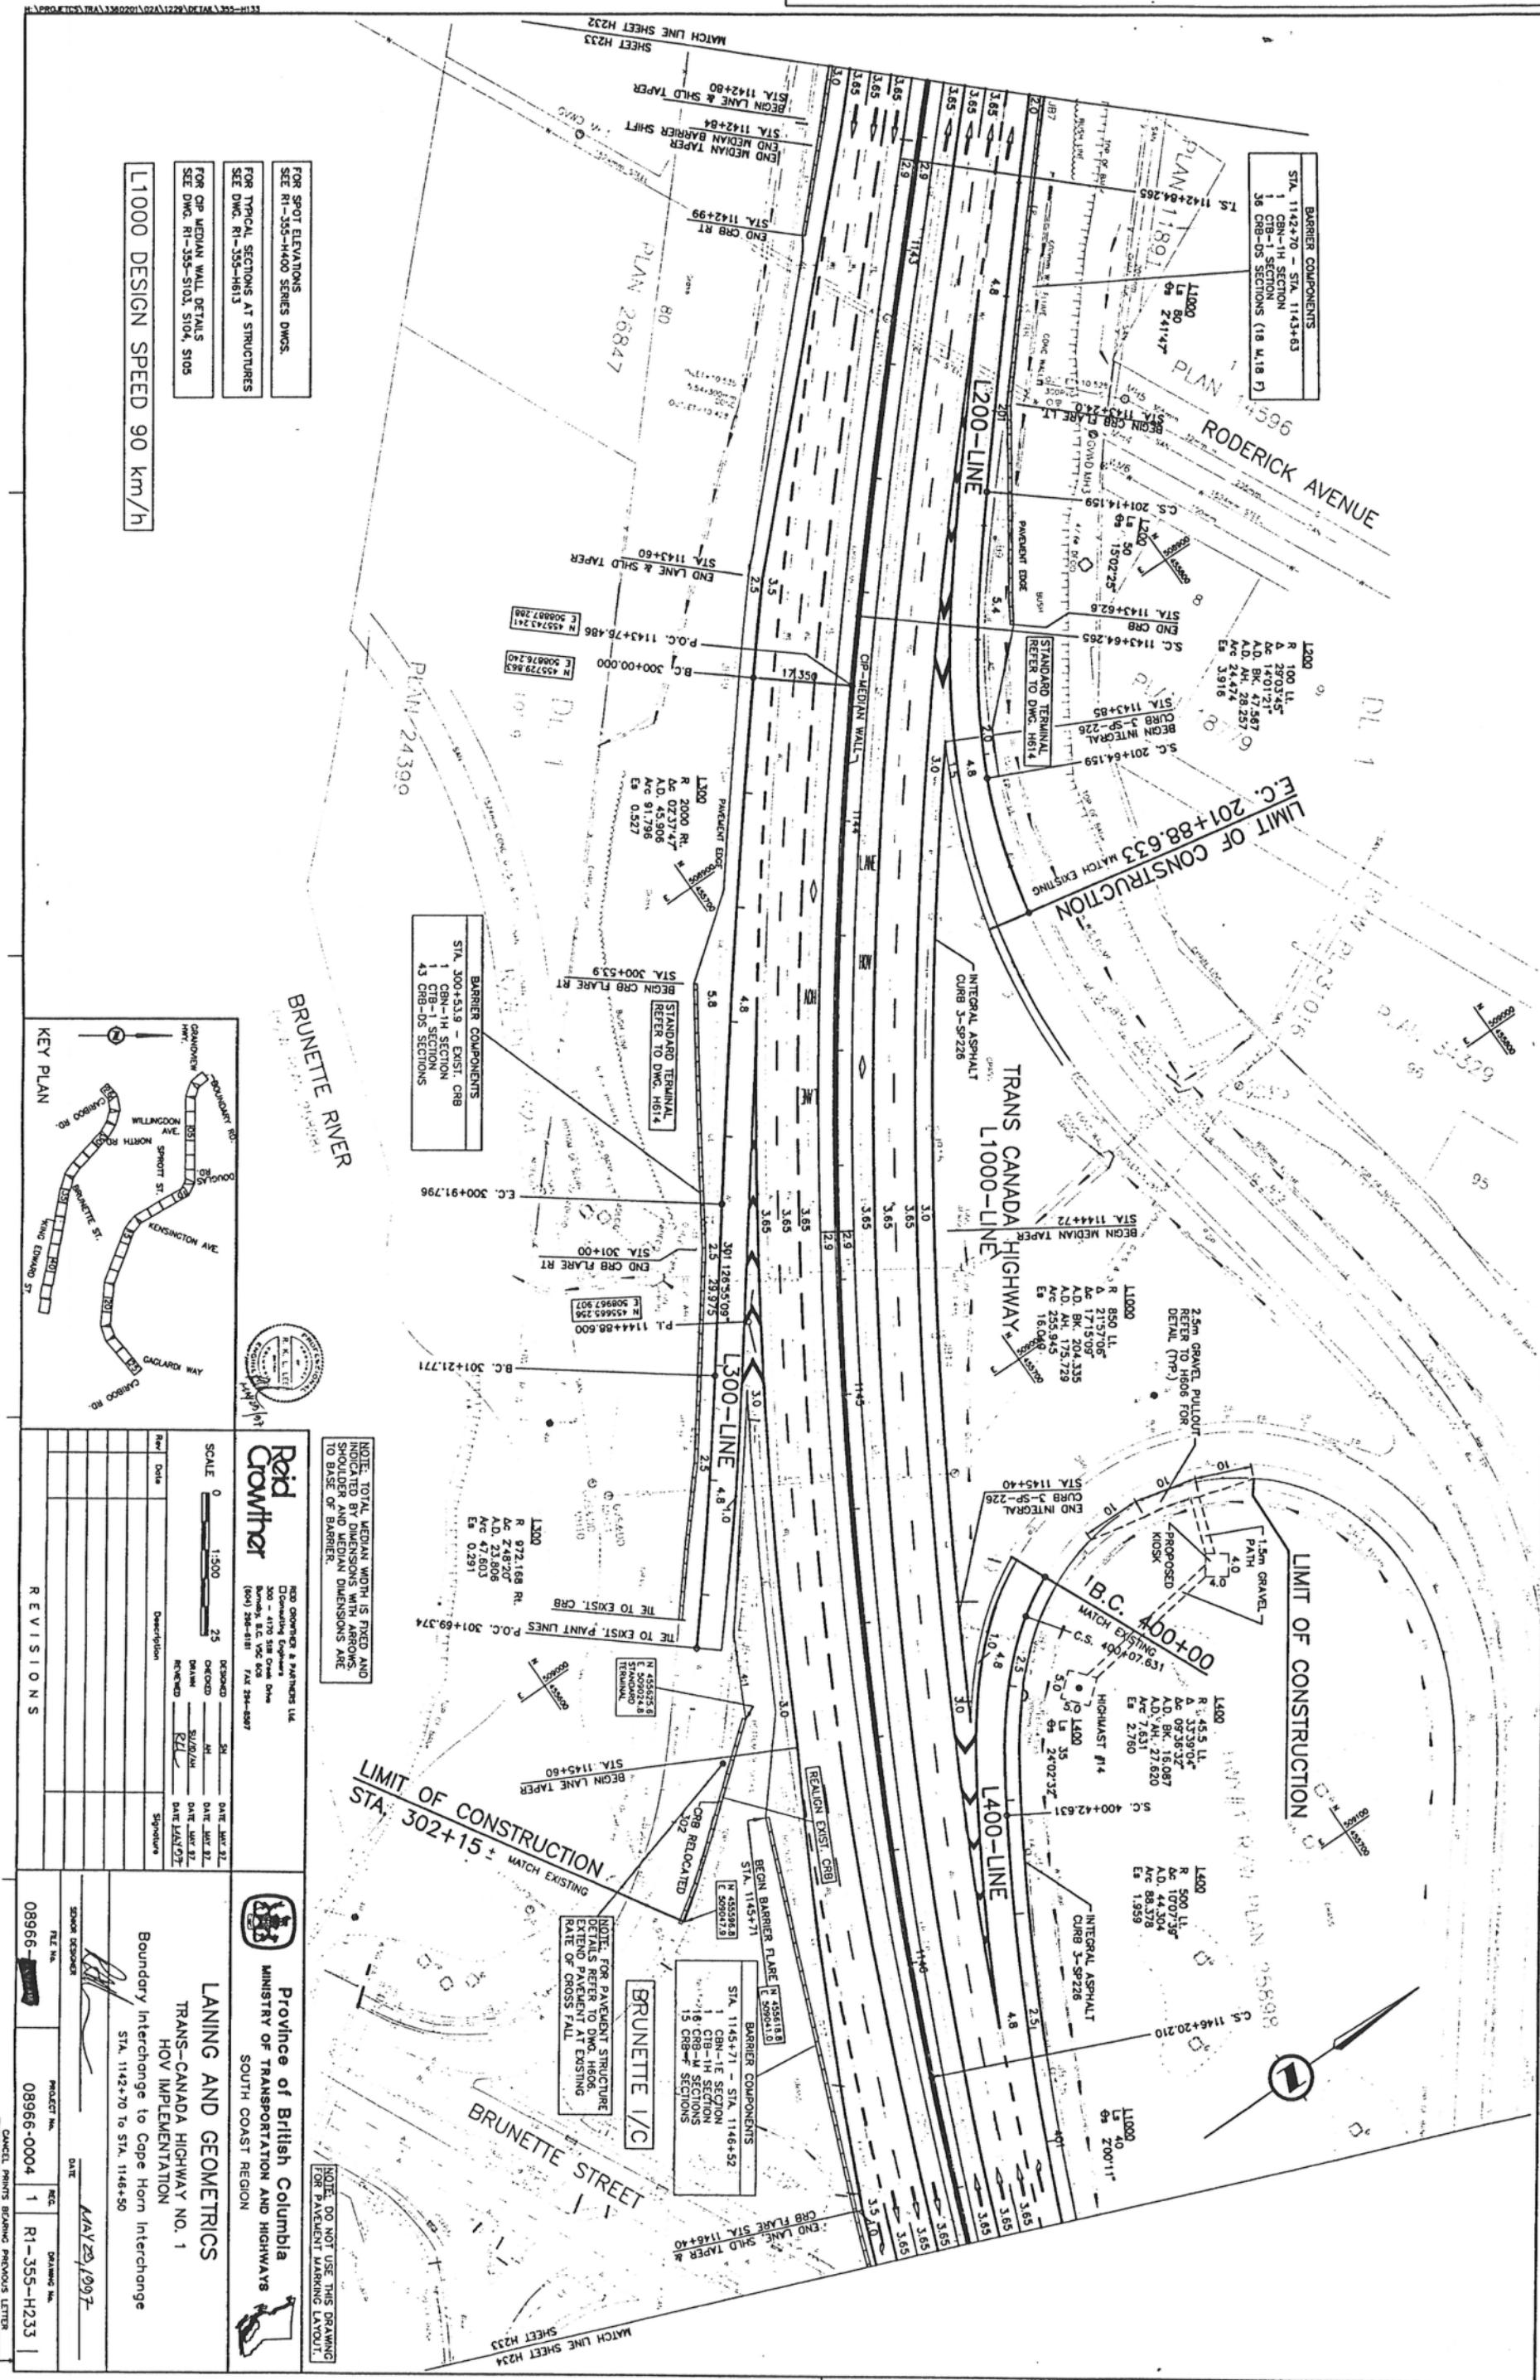

Reid Crowther
P. Eng.


REID CROWTHER & PARTNERS LTD.
Civil Engineering
300 - 470 St. James Street
Vancouver, B.C. V6C 2E6
(604) 266-8111 Fax 266-8087



Province of British Columbia
MINISTRY OF TRANSPORTATION AND HIGHWAYS
SOUTH COAST REGION

LANING AND GEOMETRICS
TRANS-CANADA HIGHWAY NO. 1
HOV IMPLEMENTATION


Boundary Interchange to Cape Horn Interchange
STA. 1142+70 to STA. 1146+50

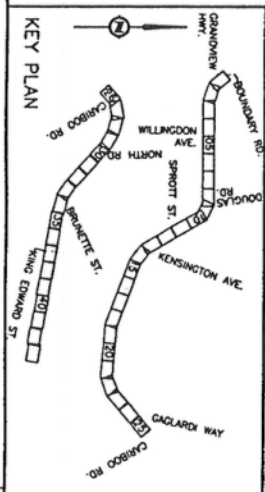

Rev	Date	Description	Signature
1	2017	Initial Design	
2	2017	Final Design	

REVISIONS	DATE	BY	CHKD	APPD
1	2017	REID CROWTHER		
2	2017	REID CROWTHER		

PROJECT No. 08966-0004
SHEET No. 1
DATE MAY 23, 2017
DRAWING No. R1-355-H233

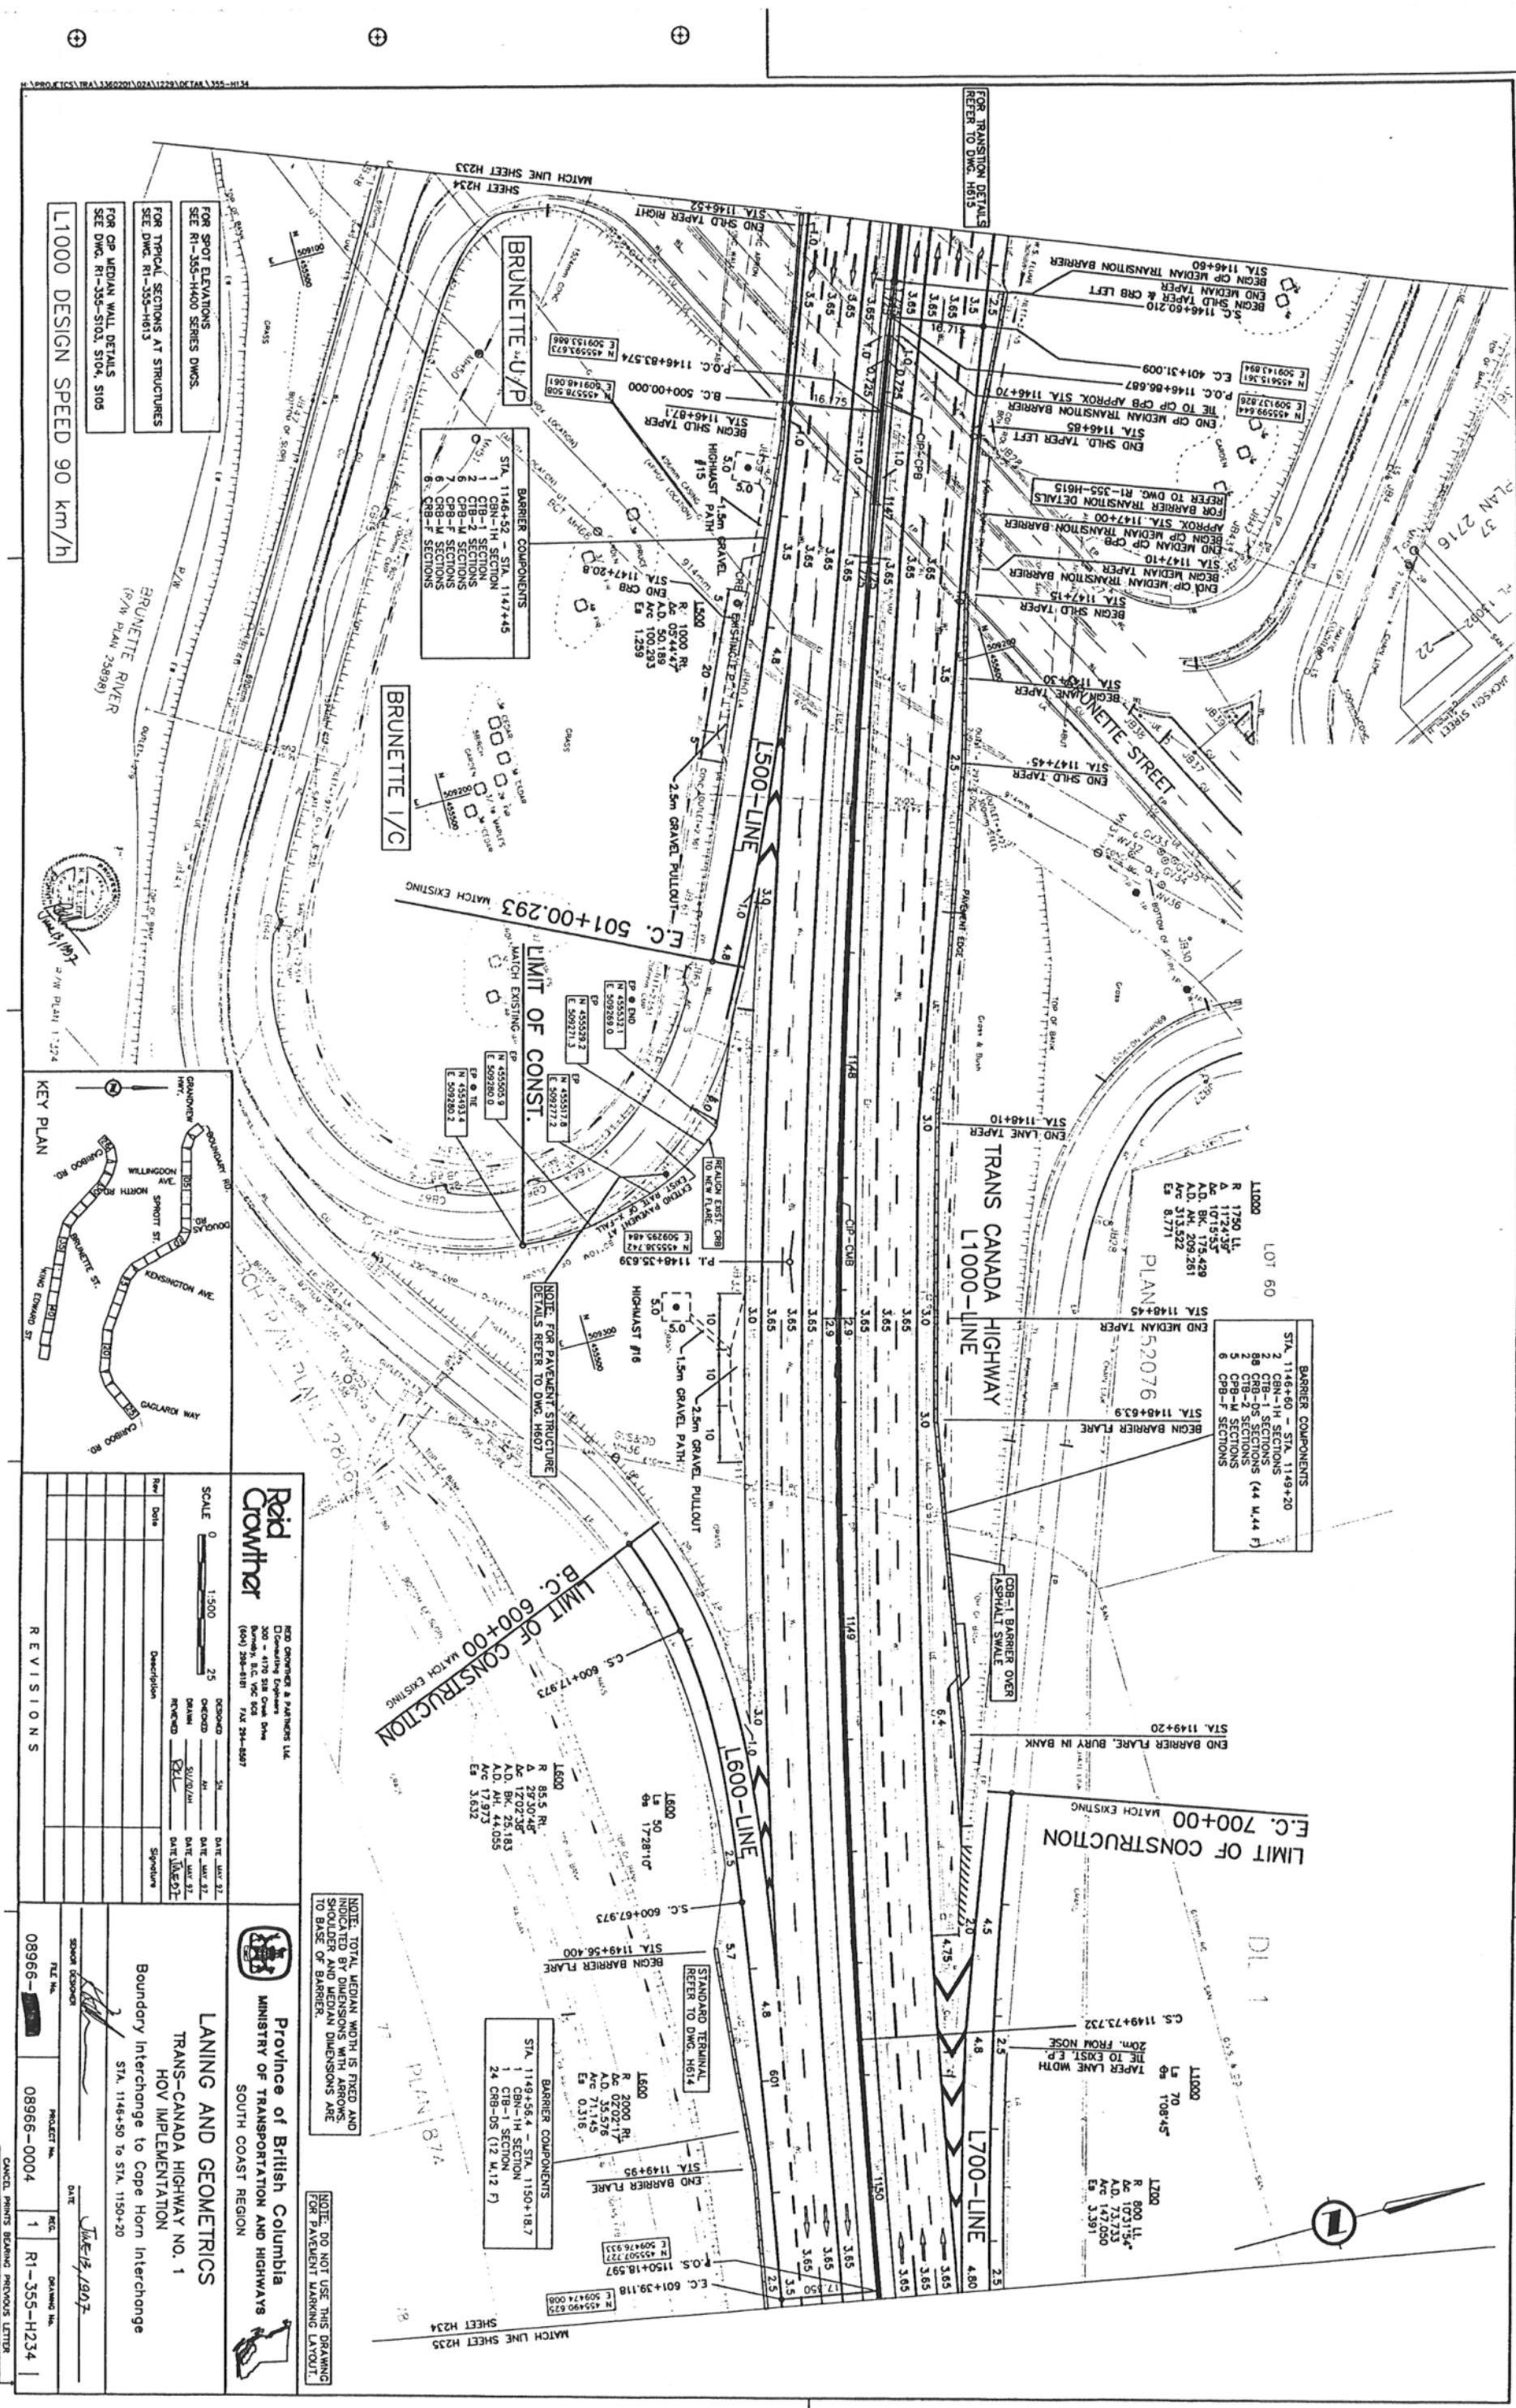


FOR SPOT ELEVATIONS
SEE RI-355-H400 SERIES DWGS.

FOR TYPICAL SECTIONS AT STRUCTURES
SEE DWG. RI-355-H613

FOR CP MEDIAN WALL DETAILS
SEE DWG. RI-355-S103, S104, S105

L1000 DESIGN SPEED 90 km/h

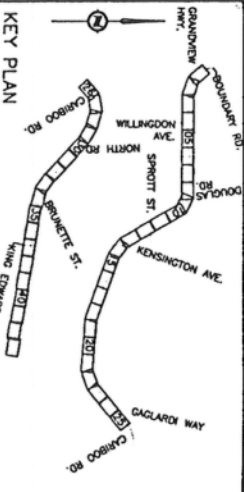

REVISIONS		DATE		BY		DESCRIPTION	
1		11/15/2017		RL		DESIGNED	
2		11/15/2017		RL		DRAWN	
3		11/15/2017		RL		CHECKED	
4		11/15/2017		RL		SIGNED	

Province of British Columbia
MINISTRY OF TRANSPORTATION AND HIGHWAYS
SOUTH COAST REGION

LANING AND GEOMETRICS
TRANS-CANADA HIGHWAY NO. 1
HOV IMPLEMENTATION
Boundary Interchange to Cape Horn Interchange
STA. 1146+50 TO STA. 1150+20


DATE: 11/15/2017


PROJECT NO.: 08966-0004

DRAWING NO.: RI-355-H234

NOTE: TOTAL MEDIAN WIDTH IS FIXED AND INDICATED BY DIMENSIONS WITH ARROWS. SHOULDER AND MEDIAN DIMENSIONS ARE TO BASE OF BARRIER.

NOTE: DO NOT USE THIS DRAWING FOR PAYMENT WARNING LAYOUT.

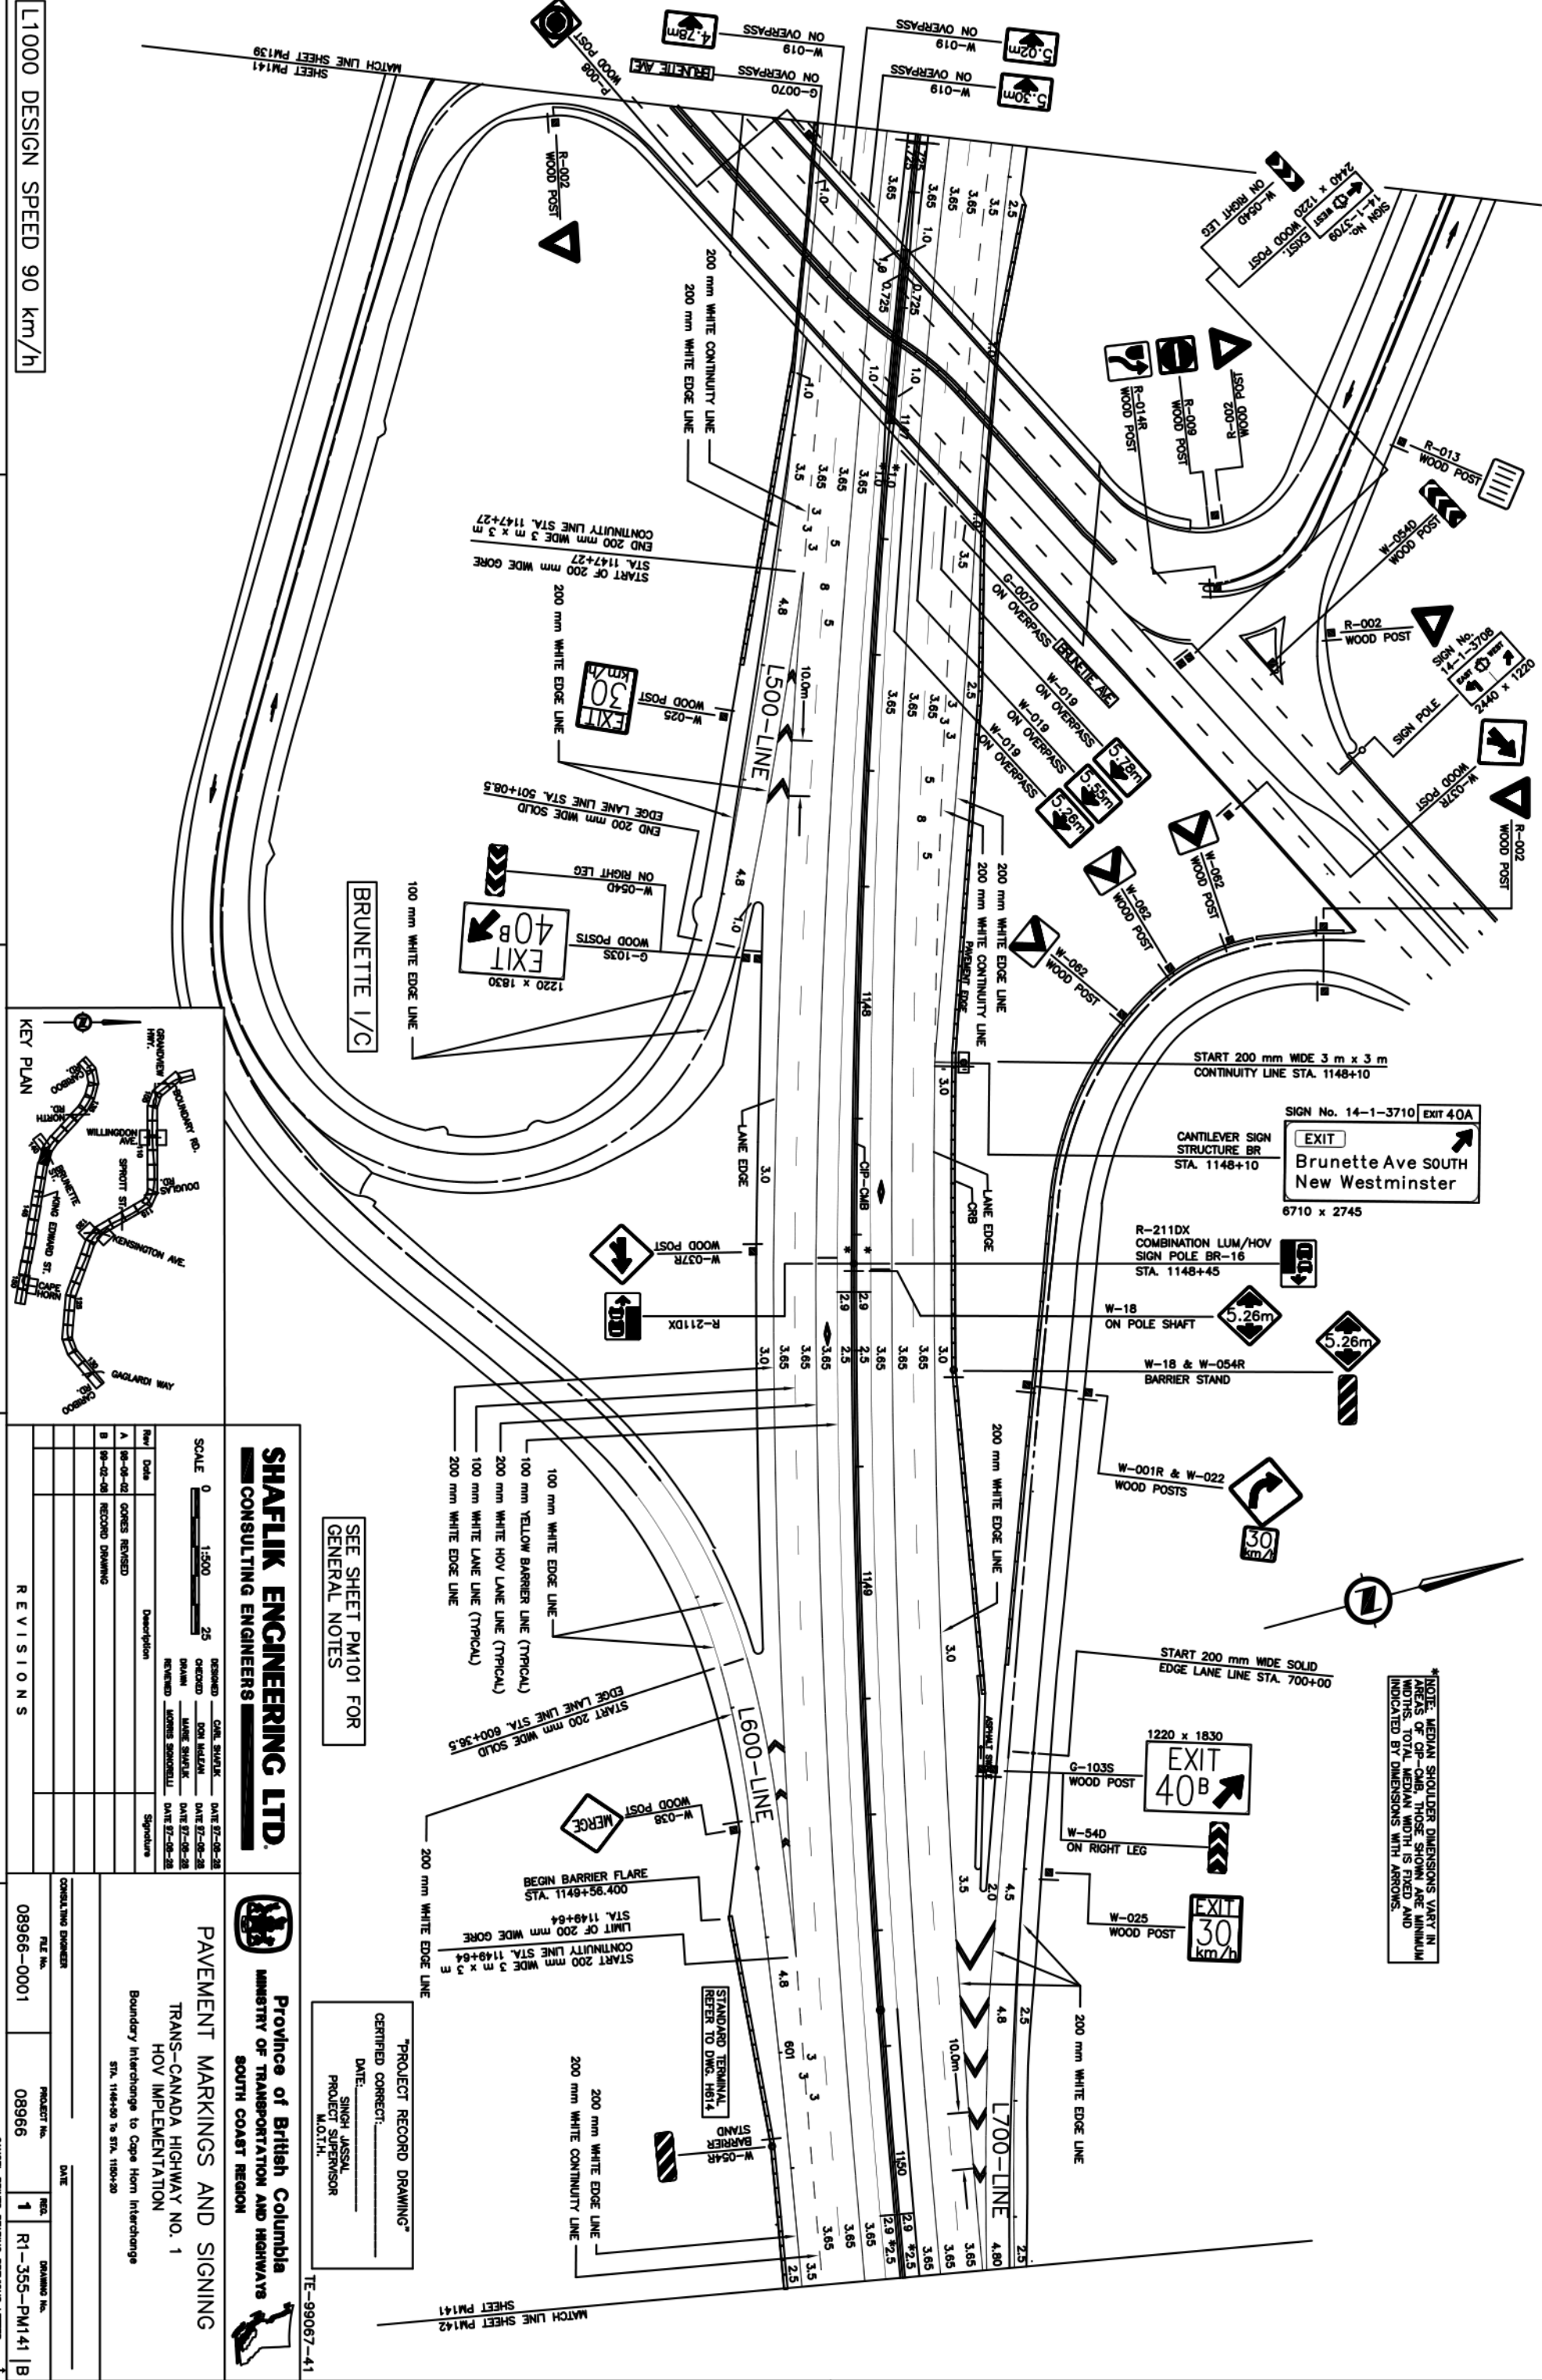

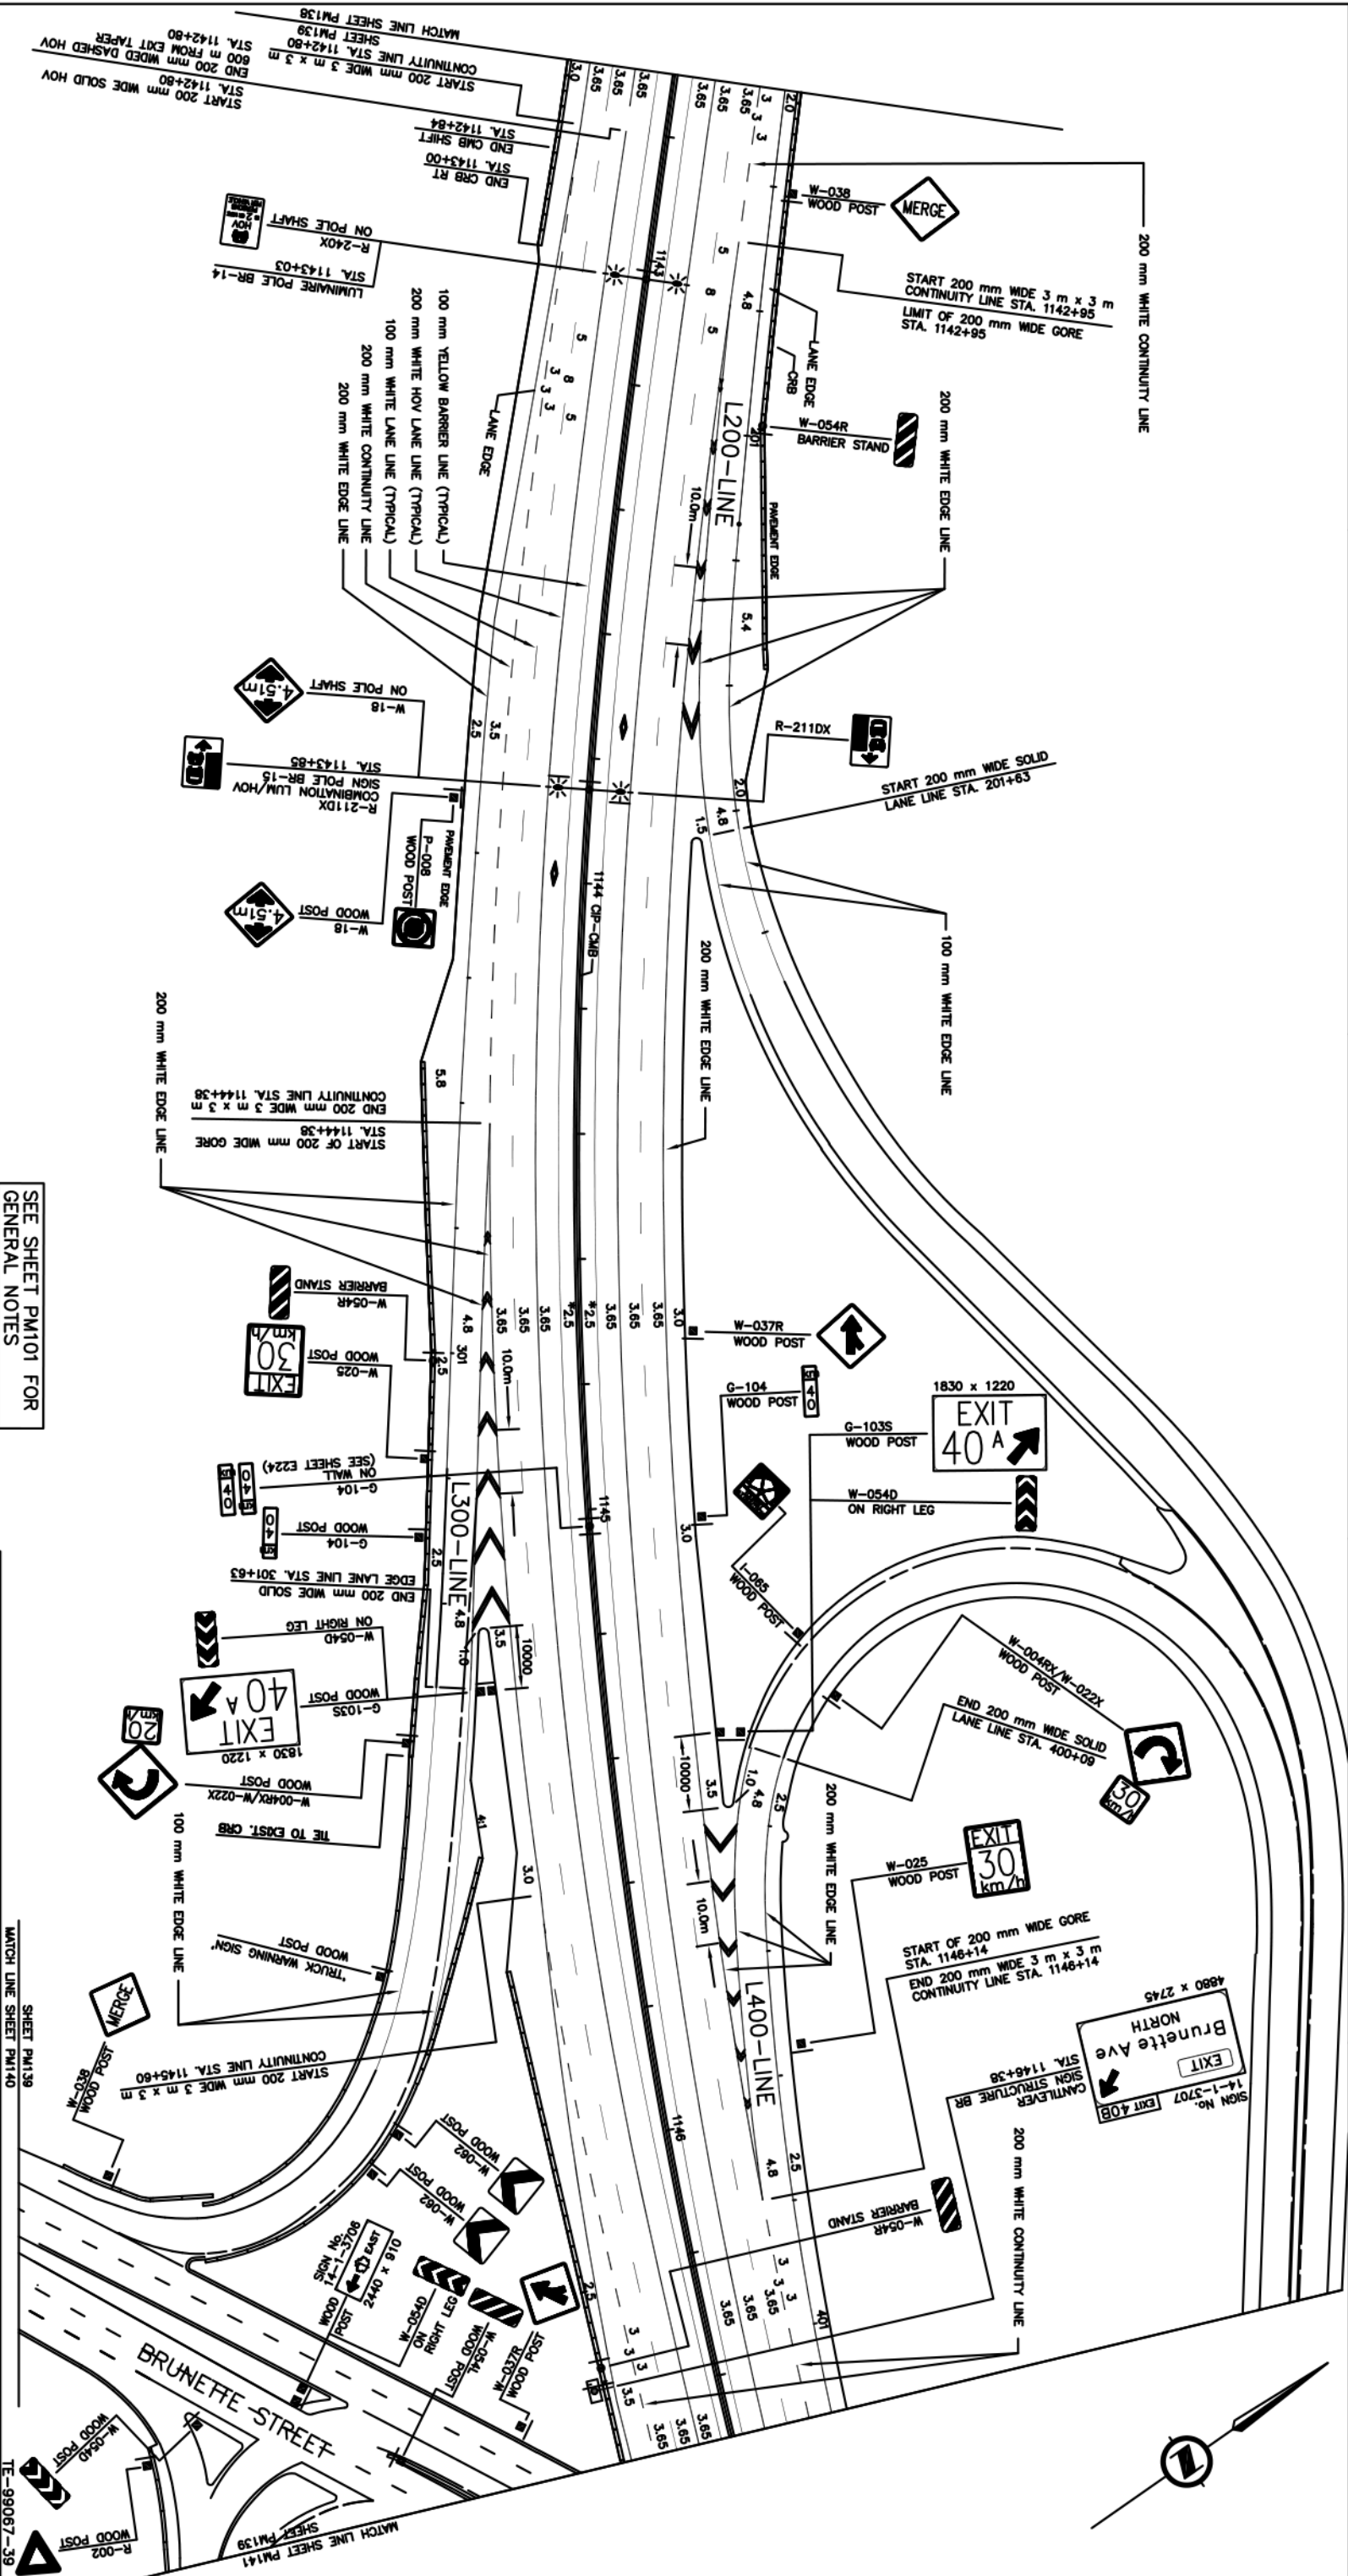

SEE SHEET PM101 FOR
GENERAL NOTES

L1000 DESIGN SPEED 90 km/h

"PROJECT RECORD DRAWING"
CERTIFIED CORRECT: _____
DATE: _____
SINGH JASSAL
PROJECT SUPERVISOR
M.O.T.A.



REVISIONS		DATE	DESCRIPTION	SIGNATURE
A	08-02-28	08-02-28	GOVT. REVIEW	
B	08-02-28	08-02-28	RECORD DRAWING	

SHAFLIK ENGINEERING LTD.
CONSULTING ENGINEERS

Province of British Columbia
MINISTRY OF TRANSPORTATION AND HIGHWAYS
SOUTH COAST REGION

PAVEMENT MARKINGS AND SIGNING

TRANS-CANADA HIGHWAY NO. 1
HOV IMPLEMENTATION

Boundary interchange to Cape Horn Interchange
STA. 1142+70 to STA. 1144+90

CONSULTING ENGINEER	FILE NO.	PROJECT NO.	REV.	DRAWING NO.
08966-0001	08966	1	R1-355-PM139	B

