



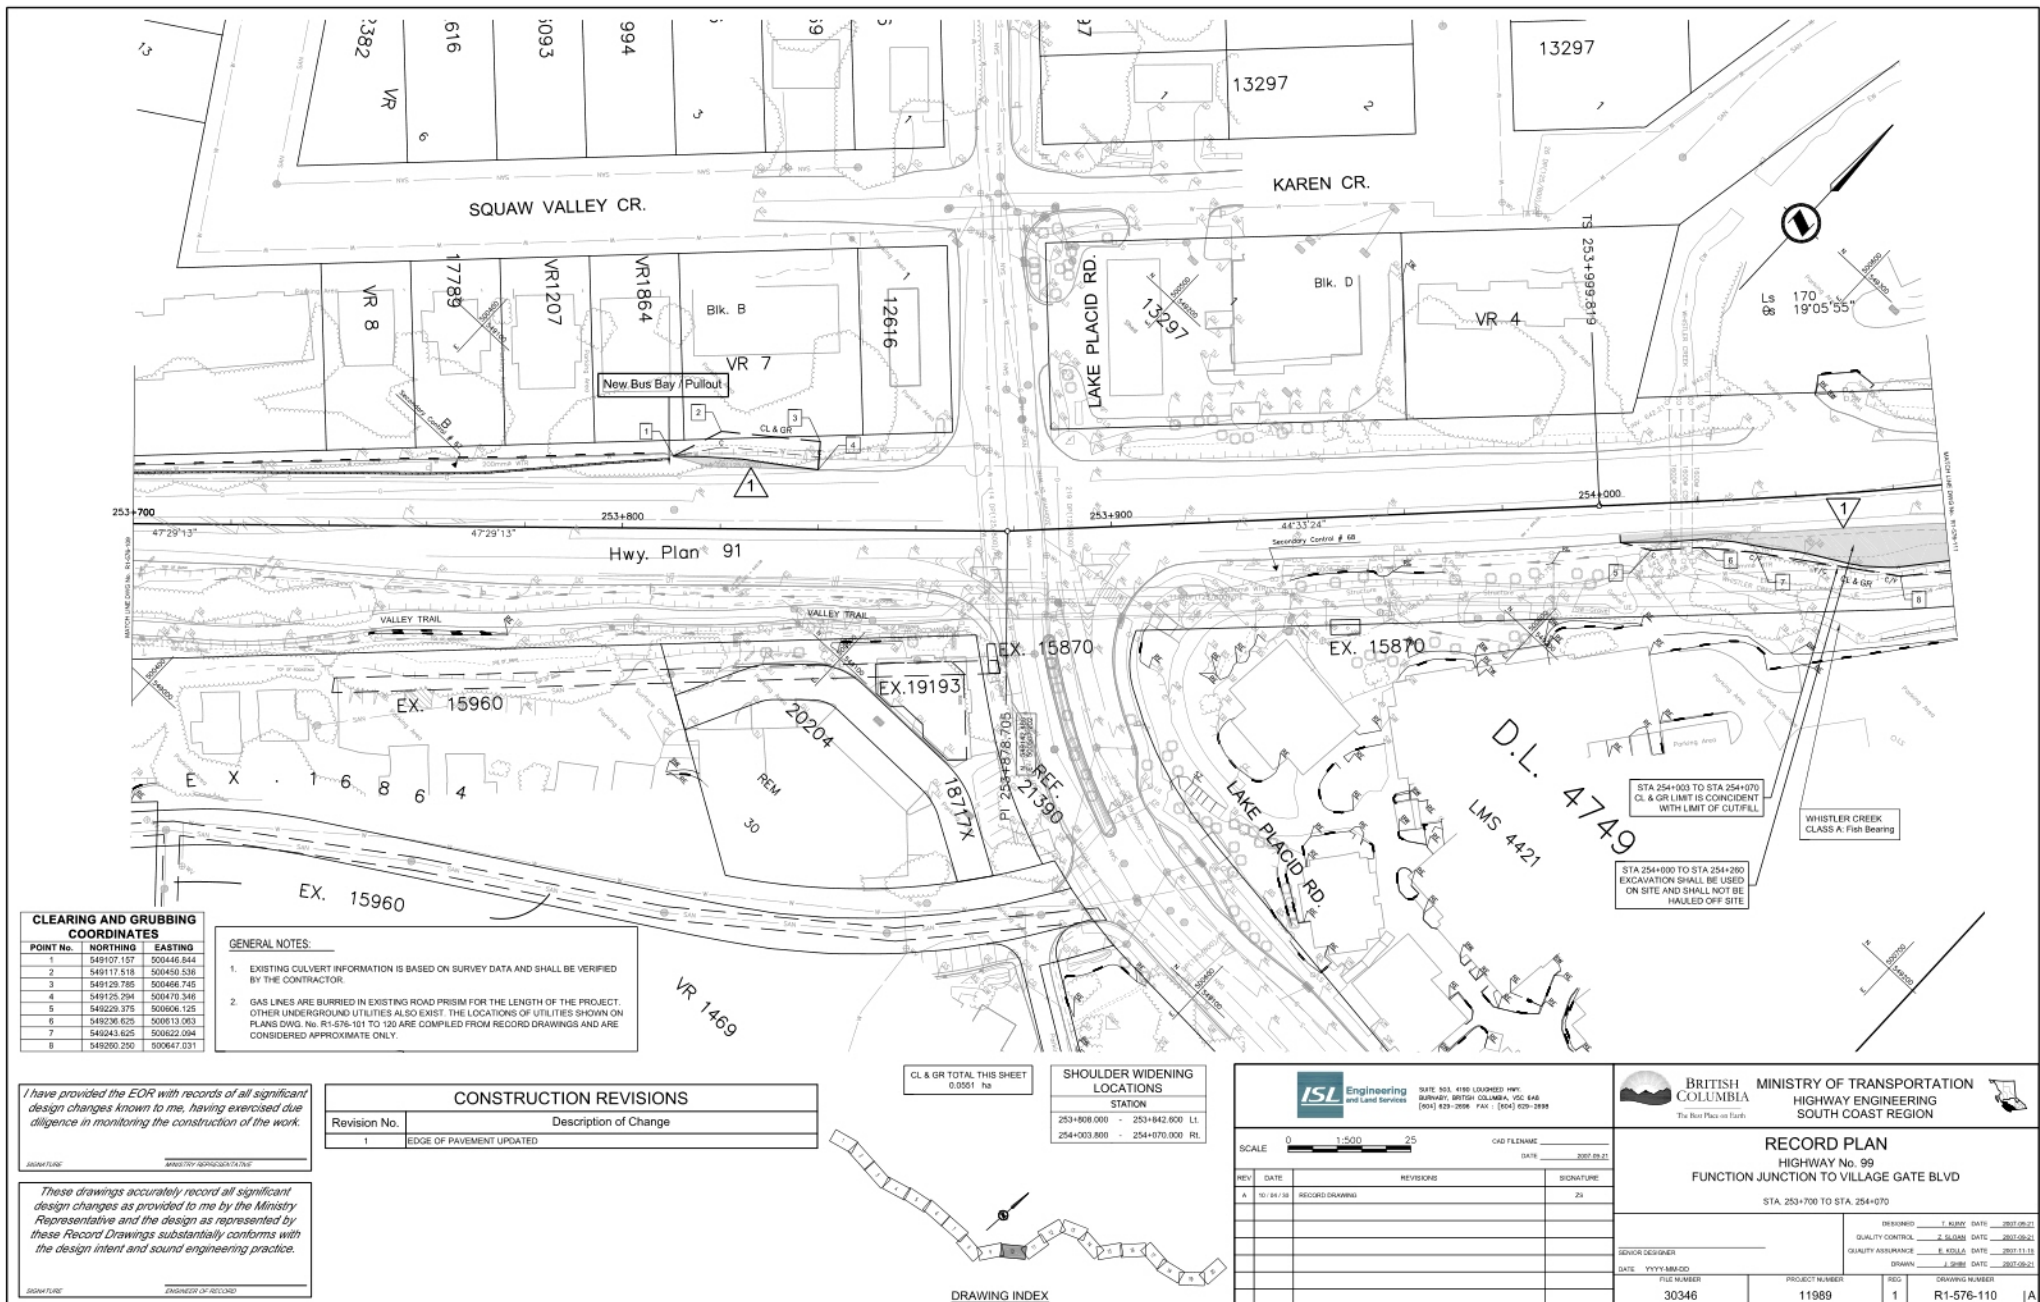

CLEARING AND GRUBBING COORDINATES		
POINT No.	NORTHING	EASTING
1	549275.875	500660.406
2	549286.500	500677.938
3	549310.882	500694.191
4	549311.478	500696.894
5	549322.306	500686.806
6	549373.986	500711.140
7	549386.038	500716.188
8	549406.562	500722.897
9	549418.813	500724.375
10	549447.500	500728.969
11	549478.438	500729.969
12	549496.063	500728.813
13	549509.605	500728.312
14	549530.378	500726.687
15	549558.125	500719.312
16	549600.460	500703.368
17	549601.381	500701.019

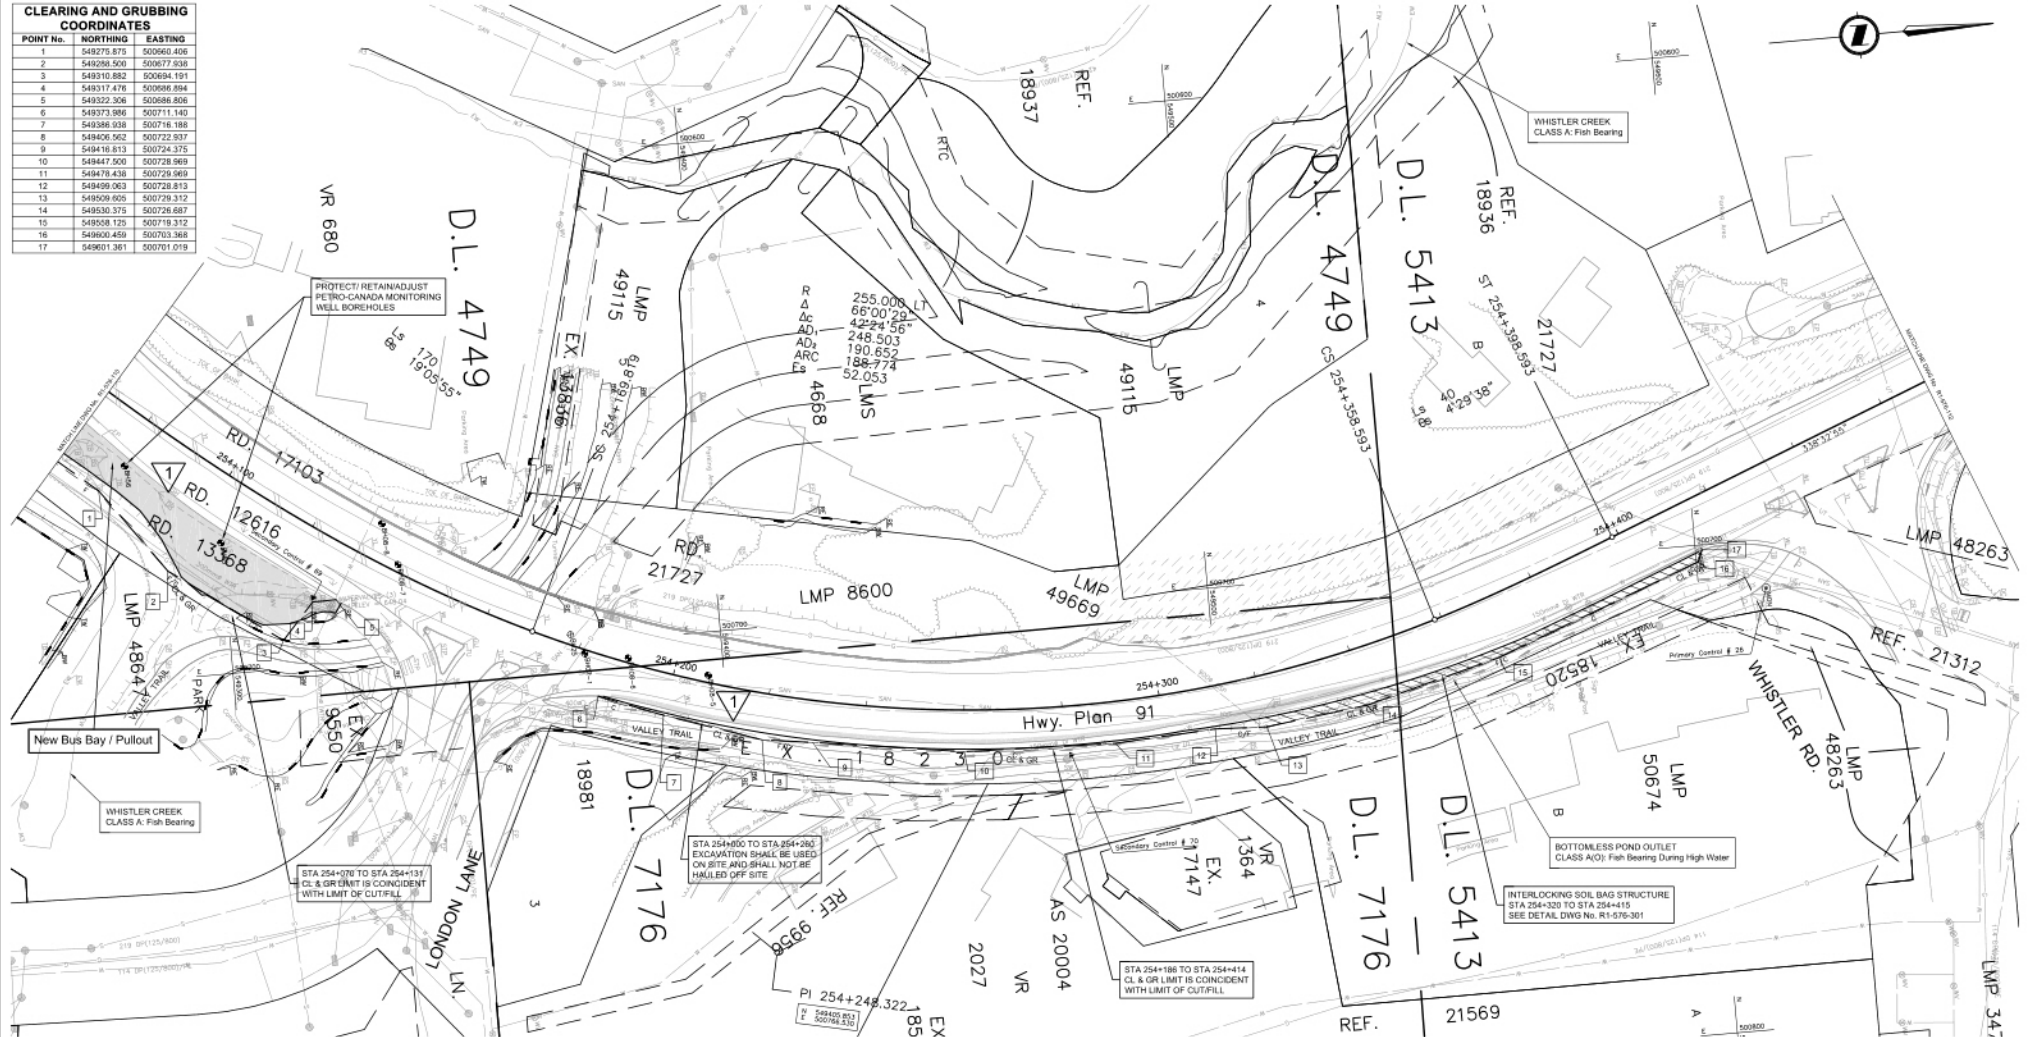

I have provided the EOR with records of all significant design changes known to me, having exercised due diligence in monitoring the construction of the work.

 SIGNATURE
 MINISTRY OF TRANSPORTATION


These drawings accurately record all significant design changes as provided to me by the Ministry Representative and the design as represented by these Record Drawings substantially conforms with the design intent and sound engineering practice.

 SIGNATURE
 ENGINEER OF RECORD

CONSTRUCTION REVISIONS	
Revision No.	Description of Change
1	EDGE OF PAVEMENT UPDATED


- GENERAL NOTES:**
- EXISTING CULVERT INFORMATION IS BASED ON SURVEY DATA AND SHALL BE VERIFIED BY THE CONTRACTOR.
 - GAS LINES ARE BURIED IN EXISTING ROAD PRISM FOR THE LENGTH OF THE PROJECT. OTHER UNDERGROUND UTILITIES ALSO EXIST. THE LOCATIONS OF UTILITIES SHOWN ON PLANS DWS. No. R1-576-101 TO 130 ARE COMPILED FROM RECORD DRAWINGS AND ARE CONSIDERED APPROXIMATE ONLY.

CL & GR TOTAL THIS SHEET	0.118 ha
SHOULDER WIDENING LOCATIONS	
STATION	
254+070.000 - 254+131.300	RI
254+186.500 - 254+413.900	RI

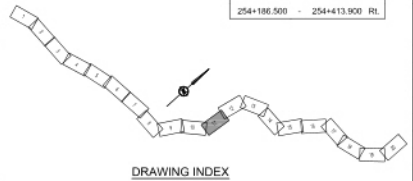

		DATE: 2017.09.21 DRAWN: J. K. B. / J. K. B. CHECKED: J. K. B. / J. K. B.	
SCALE: 0 1:500 25 CAD FILENAME: 2017.09.21		DATE: 2017.09.21	
REV	DATE	REVISIONS	SIGNATURE
A	10/01/18	RECORD DRAWING	25

		MINISTRY OF TRANSPORTATION HIGHWAY ENGINEERING SOUTH COAST REGION	
RECORD PLAN HIGHWAY No. 99 FUNCTION JUNCTION TO VILLAGE GATE BLVD STA. 254+070 TO STA. 254+470			
DESIGNED	J. K. B.	DATE	2017.09.21
QUALITY CONTROL	J. K. B.	DATE	2017.09.21
QUALITY ASSURANCE	J. K. B.	DATE	2017.11.18
DRAWN	J. K. B.	DATE	2017.09.21
DATE	2017.09.21	PROJECT NUMBER	11989
FILE NUMBER	30346	REV	1
DRAWING NUMBER	R1-576-111		

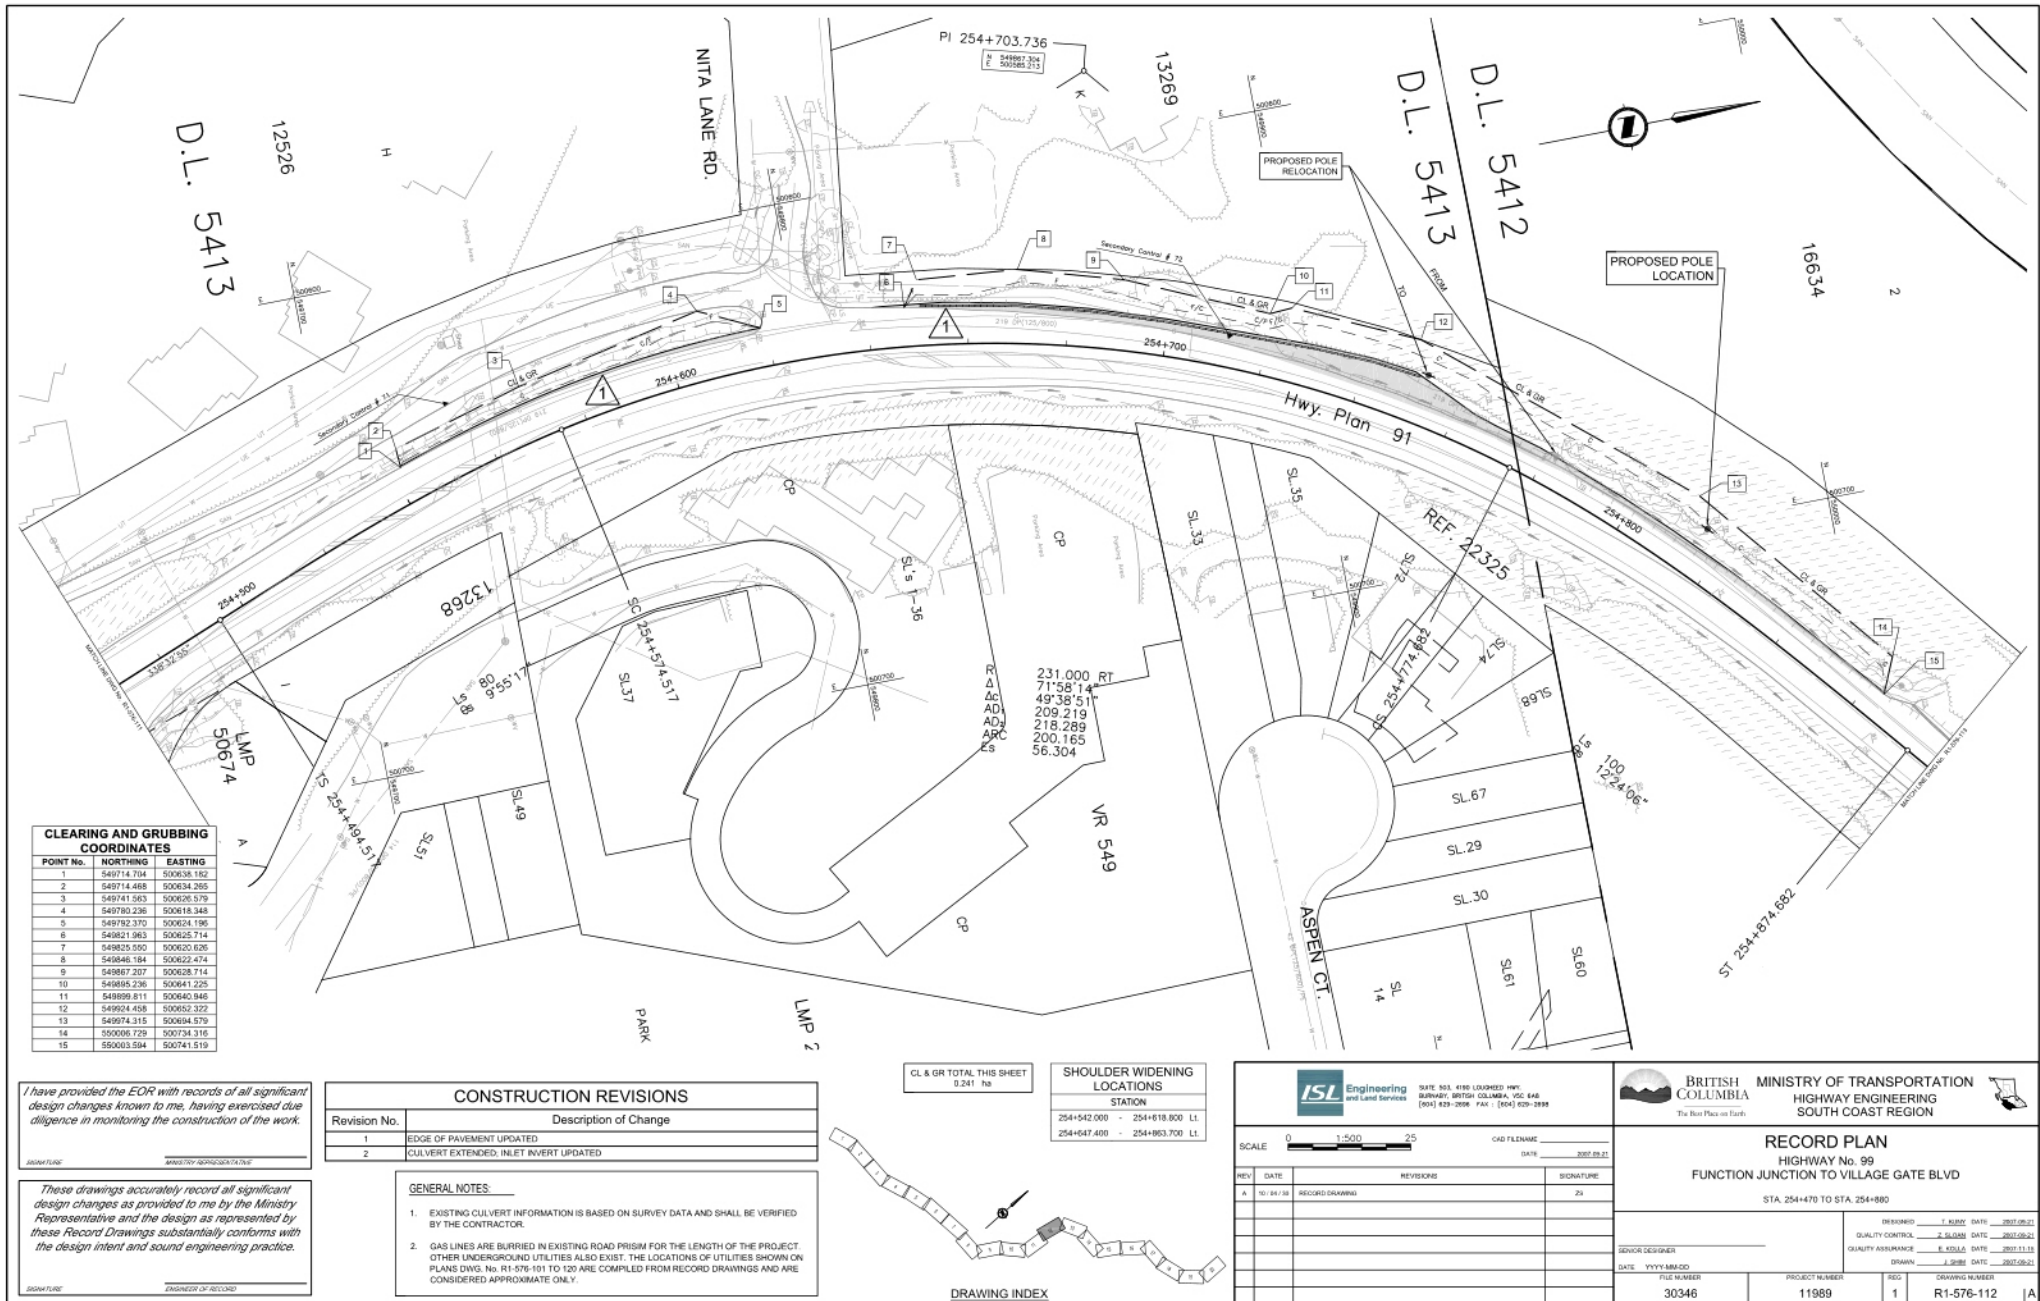

CLEARING AND GRUBBING COORDINATES

POINT No.	NORTHING	EASTING
1	549714.704	500635.182
2	549714.468	500634.265
3	549741.563	500626.579
4	549780.236	500618.348
5	549782.370	500624.186
6	549821.983	500625.714
7	549823.552	500622.636
8	549846.184	500622.474
9	549867.207	500628.714
10	549895.236	500641.225
11	549899.811	500642.845
12	549924.458	500652.322
13	549974.315	500694.579
14	550006.729	500734.316
15	550003.584	500741.519

CONSTRUCTION REVISIONS

Revision No.	Description of Change
1	EDGE OF PAVEMENT UPDATED
2	CULVERT EXTENDED, INLET INVERT UPDATED

GENERAL NOTES:

- EXISTING CULVERT INFORMATION IS BASED ON SURVEY DATA AND SHALL BE VERIFIED BY THE CONTRACTOR.
- GAS LINES ARE BURIED IN EXISTING ROAD PRISM FOR THE LENGTH OF THE PROJECT. OTHER UNDERGROUND UTILITIES ALSO EXIST. THE LOCATIONS OF UTILITIES SHOWN ON PLANS DIVS. No. R1-576-101 TO 120 ARE COMPILED FROM RECORD DRAWINGS AND ARE CONSIDERED APPROXIMATE ONLY.

CL & GR TOTAL THIS SHEET
0.241 ha

SHOULDER WIDENING LOCATIONS

STATION
254+542.000 - 254+618.800 LI.
254+547.400 - 254+663.700 LI.

DRAWING INDEX



DATE: 2017.09.21
BY: J. K. B. (J. K. B.)
CHECKED: J. K. B. (J. K. B.)
DATE: 2017.09.21



MINISTRY OF TRANSPORTATION
HIGHWAY ENGINEERING
SOUTH COAST REGION

RECORD PLAN

HIGHWAY No. 99

FUNCTION JUNCTION TO VILLAGE GATE BLVD

STA. 254+470 TO STA. 254+880

DESIGNED BY: J. K. B. (J. K. B.)
DATE: 2017.09.21

QUALITY CONTROL BY: J. K. B. (J. K. B.)
DATE: 2017.09.21

QUALITY ASSURANCE BY: J. K. B. (J. K. B.)
DATE: 2017.11.18

DRAWN BY: J. K. B. (J. K. B.)
DATE: 2017.09.21

FILE NUMBER
30346

PROJECT NUMBER
11989

REVISION
1
DRAWING NUMBER
R1-576-112